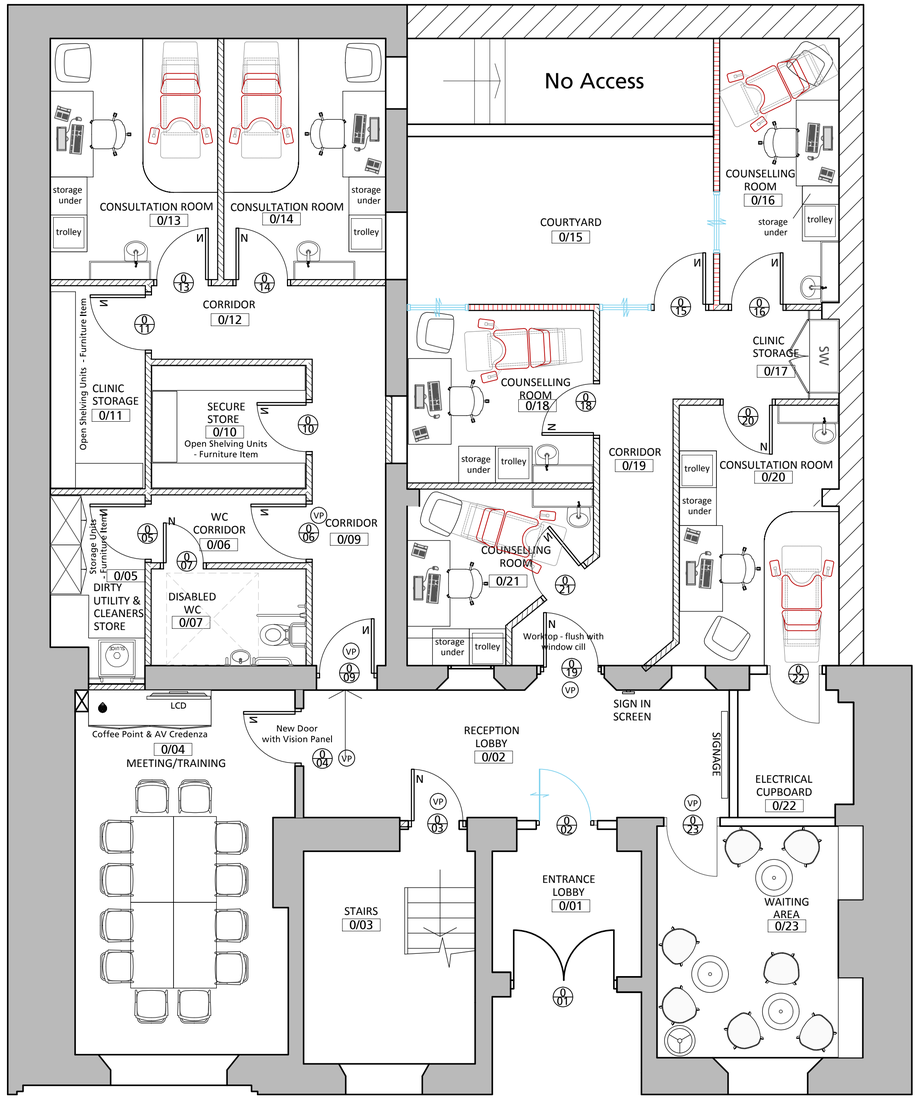

HEADCOUNT	
Consulting Rooms	3
Reception/Waiting	1
Counselling Rooms	3
12 Person Mtg/ Training	1
Elec DistributionCupd	1
New WCs	1
Store	1
Dirty Utility/Cleaners	1
Clinic Storage	1
Staff Lockers - approx	-

THIS DRAWING IS PROTECTED UNDER COPYRIGHT.
THIS DRAWING IS NOT TO BE REPRODUCED IN WHOLE OR PART UNLESS AUTHORISED BY area²
© COPYRIGHT
THIS DRAWING IS NOT TO BE SCALED
THE GENERAL CONTRACTOR IS TO CHECK ALL DIMENSIONS AND NOTIFY THE DESIGNERS OF ANY DISCREPANCIES OR OMISSIONS.

DRAWING TO BE READ IN CONJUNCTION WITH SCOPE OF WORKS

REFERENCE:	REVISION:
-	-

CEILING HEIGHT	-
BEAM HEIGHT	-
WINDOW HEIGHT	-
SILL HEIGHT	-
CEILING VOID	-
FLOOR VOID	-

THIS DRAWING IS ON RECYCLED PAPER

DATE	REV	REVISIONS	SIGN	CHKD
29.06.16	F	AS BUILT ISSUE	PH	
12.05.16	E	NEW DISABLED WC LAYOUT ADDED AS PER CLIENT INSTRUCTION; VPS SHOWN TO DOORS; SINK UNITS TO ROOMS NOW 300mm DEEP; SINK MIRRORED IN ROOM 0/13.	PH	
10.03.16	D	CONSULTATION AND COUNSELLING ROOM LAYOUTS ADJUSTED TO SHOW TROLLEY PARK & STORAGE, SINK UNITS ADJUSTED RECLINING CHAIRS SHOWN IN ROOMS FOR REFERENCE	AL	
24.02.16	C	TEAPOINT REMOVED & CONVERTED TO SECURE STORE WATER/COFFEE DISPENSER ADDED TO MEETING ROOM BACK ELEVATION AMENDED TO SHOW SINGLE DOOR INTO COURTYARD	AL	
02.02.16	B	CLINICAL ROOMS UPDATED TO SHOW BUILT IN SINK/STORAGE UNIT AND WALL MOUNTED STORAGE ABOVE DESKS, AS PER VISUALS	AL	
26.01.16	A	ADDITIONAL BUILT IN STOREWALL, RECONFIGURATION OF DIRTY UTILITY, TEAPOINT AND CLINICAL STORAGE IN LINE WITH CLIENT COMMENTS	AL	
-	-	FIRST ISSUE	-	-

area²
22 NEWMAN STREET
LONDON
W1T 1PH
T. 020 7291 9400
info@areasq.co.uk
www.areasq.co.uk

DRAWING STATUS
AS BUILT

CLIENT
ST STEPHENS AIDS TRUST

PROJECT
264 FULHAM ROAD
LONDON
SW10 9EL

TITLE
GROUND FLOOR
PROPOSED GENERAL ARRANGEMENT
UPLIFT PLAN - OPTION 3

SCALE 1:50 @ A1

DATE 20.07.15 | DRAWN PH

PROJECT NO	BLDG.	FLOOR	DETAIL	REV.
4877L	1	G	GA3	F

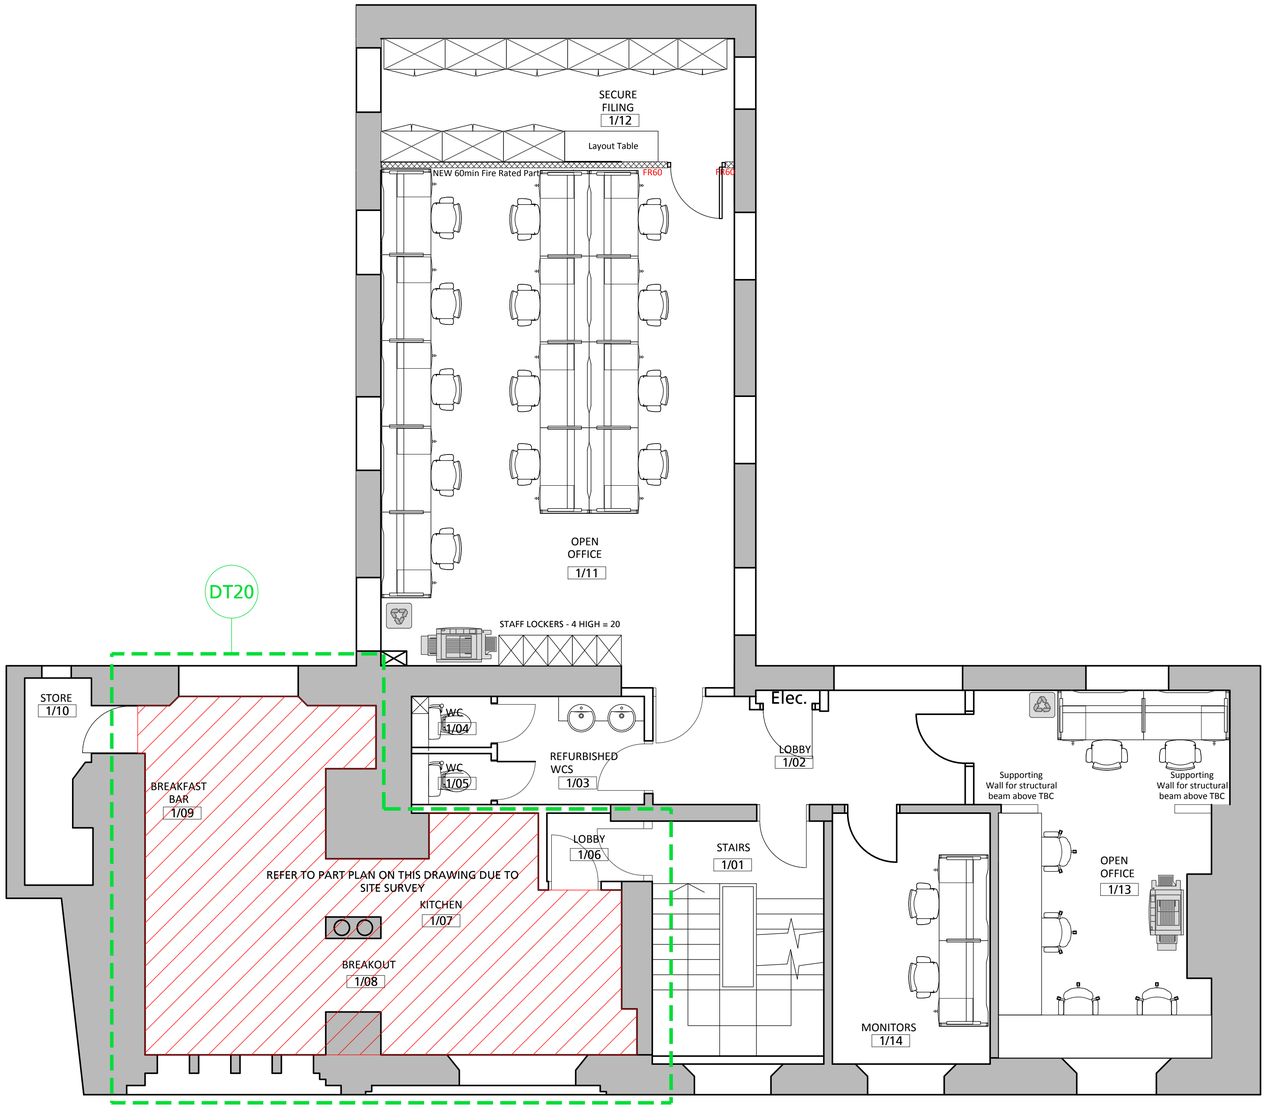

Detail Location Plan Legend

DT# Details reference

EL# Elevations reference

THIS DRAWING IS PROTECTED UNDER COPYRIGHT.
THIS DRAWING IS NOT TO BE REPRODUCED IN WHOLE OR PART UNLESS AUTHORISED BY area²
© COPYRIGHT
THIS DRAWING IS NOT TO BE SCALED
THE GENERAL CONTRACTOR IS TO CHECK ALL DIMENSIONS AND NOTIFY THE DESIGNERS OF ANY DISCREPANCIES OR OMISSIONS.

DRAWING TO BE READ IN CONJUNCTION WITH SCOPE OF WORKS

REFERENCE:	REVISION:
-	-

CEILING HEIGHT	-
BEAM HEIGHT	-
WINDOW HEIGHT	-
SILL HEIGHT	-
CEILING VOID	-
FLOOR VOID	-

THIS DRAWING IS ON RECYCLED PAPER

DATE	REV	REVISIONS	SIGN	CHKD
29.06.16	A	AS BUILT ISSUE	PH	--
28.10.15	-	CONSTRUCTION ISSUE	PH	CB

area²
22 NEWMAN STREET
LONDON
W1T 1PH
T. 020 7291 9400
info@areasq.co.uk
www.areasq.co.uk

DRAWING STATUS
CONSTRUCTION

CLIENT
ST STEPHENS AIDS TRUST

PROJECT
264 FULHAM ROAD
LONDON
SW10 9EL

TITLE
FIRST FLOOR
PROPOSED DETAIL LOCATION PLAN

SCALE 1:50 @ A1

DATE 20.07.15 | DRAWN PH

PROJECT NO	BLDG.	FLOOR	DETAIL	REV.
4877L	1	1	DLP	A

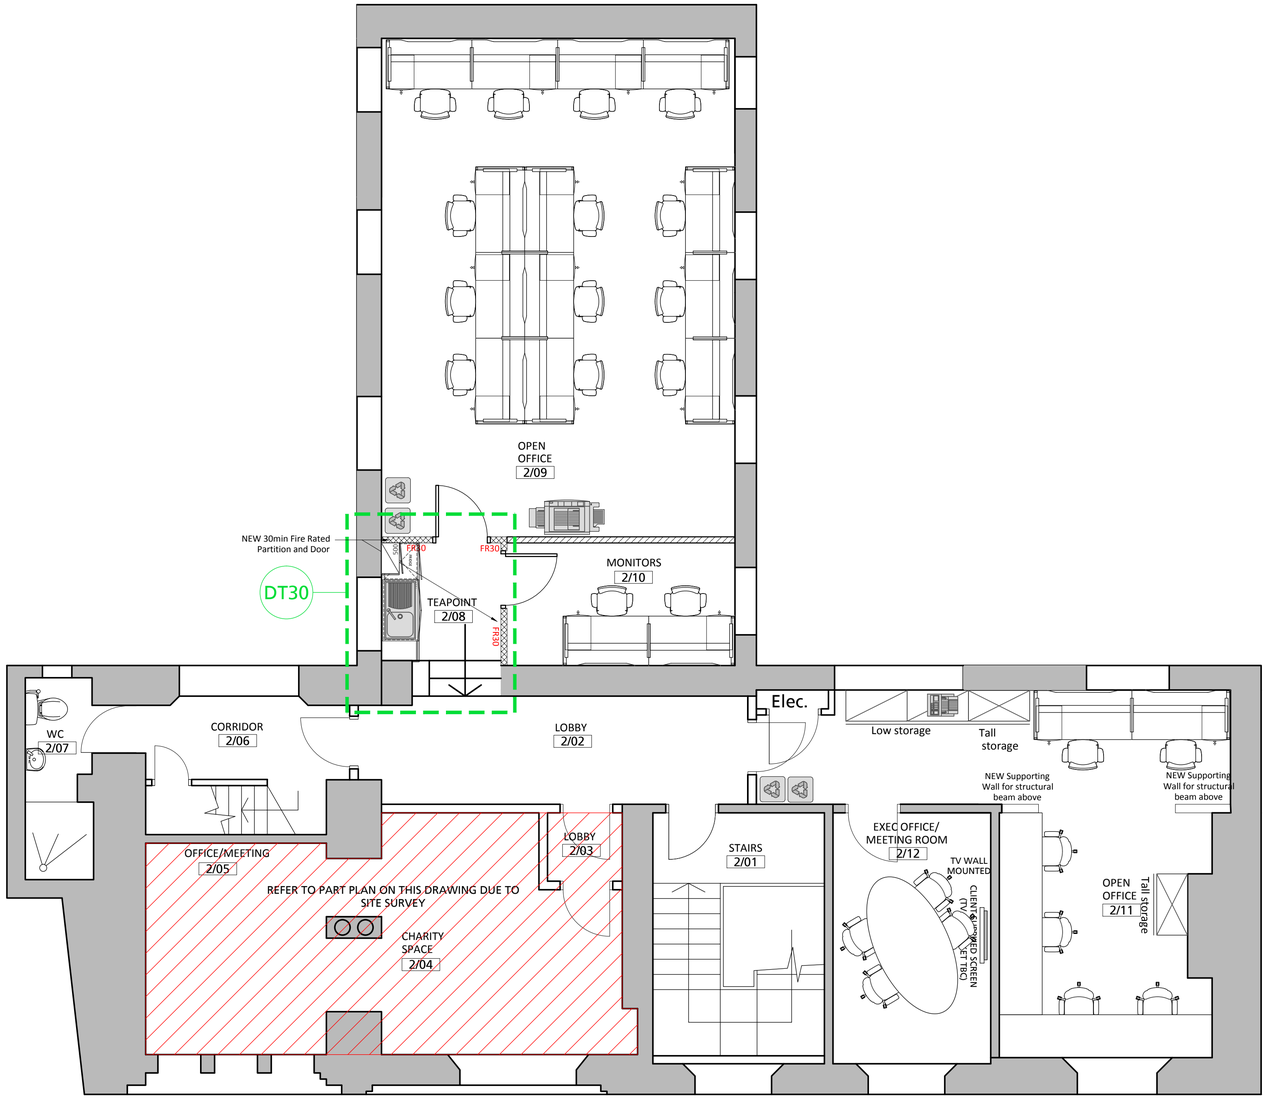

Detail Location Plan Legend

DT# Details reference

EL# Elevations reference

THIS DRAWING IS PROTECTED UNDER COPYRIGHT.
THIS DRAWING IS NOT TO BE REPRODUCED IN WHOLE OR PART UNLESS AUTHORISED BY area²
© COPYRIGHT
THIS DRAWING IS NOT TO BE SCALED
THE GENERAL CONTRACTOR IS TO CHECK ALL DIMENSIONS AND NOTIFY THE DESIGNERS OF ANY DISCREPANCIES OR OMISSIONS.

DRAWING TO BE READ IN CONJUNCTION WITH SCOPE OF WORKS

REFERENCE:	REVISION:
-	-

CEILING HEIGHT	-
BEAM HEIGHT	-
WINDOW HEIGHT	-
SILL HEIGHT	-
CEILING VOID	-
FLOOR VOID	-

THIS DRAWING IS ON RECYCLED PAPER

DATE	REV	REVISIONS	SIGN	CHKD
29.06.16	A	AS BUILT ISSUE	PH	--
28.10.15	-	CONSTRUCTION ISSUE	PH	CB

area²
22 NEWMAN STREET
LONDON
W1T 1PH
T. 020 7291 9400
info@areasq.co.uk
www.areasq.co.uk

DRAWING STATUS
AS BUILT

CLIENT
ST STEPHENS AIDS TRUST

PROJECT
264 FULHAM ROAD
LONDON
SW10 9EL

TITLE
SECOND FLOOR
PROPOSED DETAIL LOCATION
PLAN

SCALE
1:50 @ A1

DATE
20.07.15

DRAWN
PH

PROJECT NO	BLDG.	FLOOR	DETAIL	REV.
4877L	1	2	DLP	A

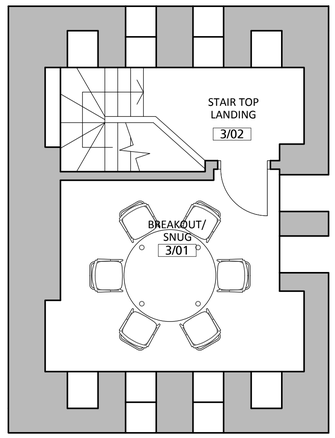

Partition Construction Legend

Existing Door to remain

New Single Leaf Door

New Glass Door with Frame

Existing Partition to Remain

New 100mm solid partition constructed from FFL to suspended ceiling level, using two sheets of 12.5mm plasterboard either side of a 48mm galvanized steel stud with Rockwool infill.

New solid partition constructed from FFL to suspended ceiling level, using 1 sheets of 15mm Fireline Board either side of a 48mm galvanized steel stud with Rockwool infill (for 60min partition).

FR30
Partition with 30 minutes fire rating

FR60
Partition with 60 minutes fire rating. 1 x layer of Gyproc Fireline (1x15mm) each side of 48mm galvanised steel stud. Taped and jointed and finished as per finishes schedule.

(P) Line Denotes Position of Ply Strengthening Within Partition

(A) Line Denotes position of Acoustic Barrier (Ceiling Void)

(F) Line Denotes position of Fire Barrier (Ceiling Void)

New full height, single glazed partition. Aluminium frame to specialist detail. Glass 6.4mm laminated. Manifestation to detail. 30mins fire rated where indicated.

SW — Storage Wall Unit (Standard Depth)

SW 600 — Storage Wall Unit - 600mm Deep

SW 600 — Storage Wall Unit - 600mm Deep with Coat Rail and Hat Shelf

1/01 — Room Label - Floor / Room No.

(01) — Door Label - Floor / Door No.

(VP) — Vision panel

(SC) — Self closing device

(DL) — Digital keypad lock

(AC) — Electronic access control

THIS DRAWING IS PROTECTED UNDER COPYRIGHT.
THIS DRAWING IS NOT TO BE REPRODUCED IN WHOLE OR PART UNLESS AUTHORISED BY area²
© COPYRIGHT
THIS DRAWING IS NOT TO BE SCALED
THE GENERAL CONTRACTOR IS TO CHECK ALL DIMENSIONS AND NOTIFY THE DESIGNERS OF ANY DISCREPANCIES OR OMISSIONS.

DRAWING TO BE READ IN CONJUNCTION WITH SCOPE OF WORKS

REFERENCE:	REVISION:
-	-

CEILING HEIGHT	-
BEAM HEIGHT	-
WINDOW HEIGHT	-
SILL HEIGHT	-
CEILING VOID	-
FLOOR VOID	-

THIS DRAWING IS ON RECYCLED PAPER

DATE	REV	REVISIONS	SIGN	CHKD
29.06.16	C	AS BUILT ISSUE	PH	--
19.11.15	B	CIRCULAR TABLE ADDED REF AL.	PH	AL
28.10.15	A	CONSTRUCTION ISSUE	PH	CB
14.10.15	-	FIRST ISSUE	PH	IM

area²
22 NEWMAN STREET
LONDON
W1T 1PH
T. 020 7291 9400
info@areasq.co.uk
www.areasq.co.uk

DRAWING STATUS
AS BUILT

CLIENT
ST STEPHENS AIDS TRUST

PROJECT
264 FULHAM ROAD
LONDON
SW10 9EL

TITLE
THIRD FLOOR
PROPOSED GENERAL ARRANGEMENT PLAN

SCALE
1:50 @ A1

DATE
20.07.15

DRAWN
PH

PROJECT NO	BLDG.	FLOOR	DETAIL	REV.
4877L	1	3	GA	C